




LANGDON WATER

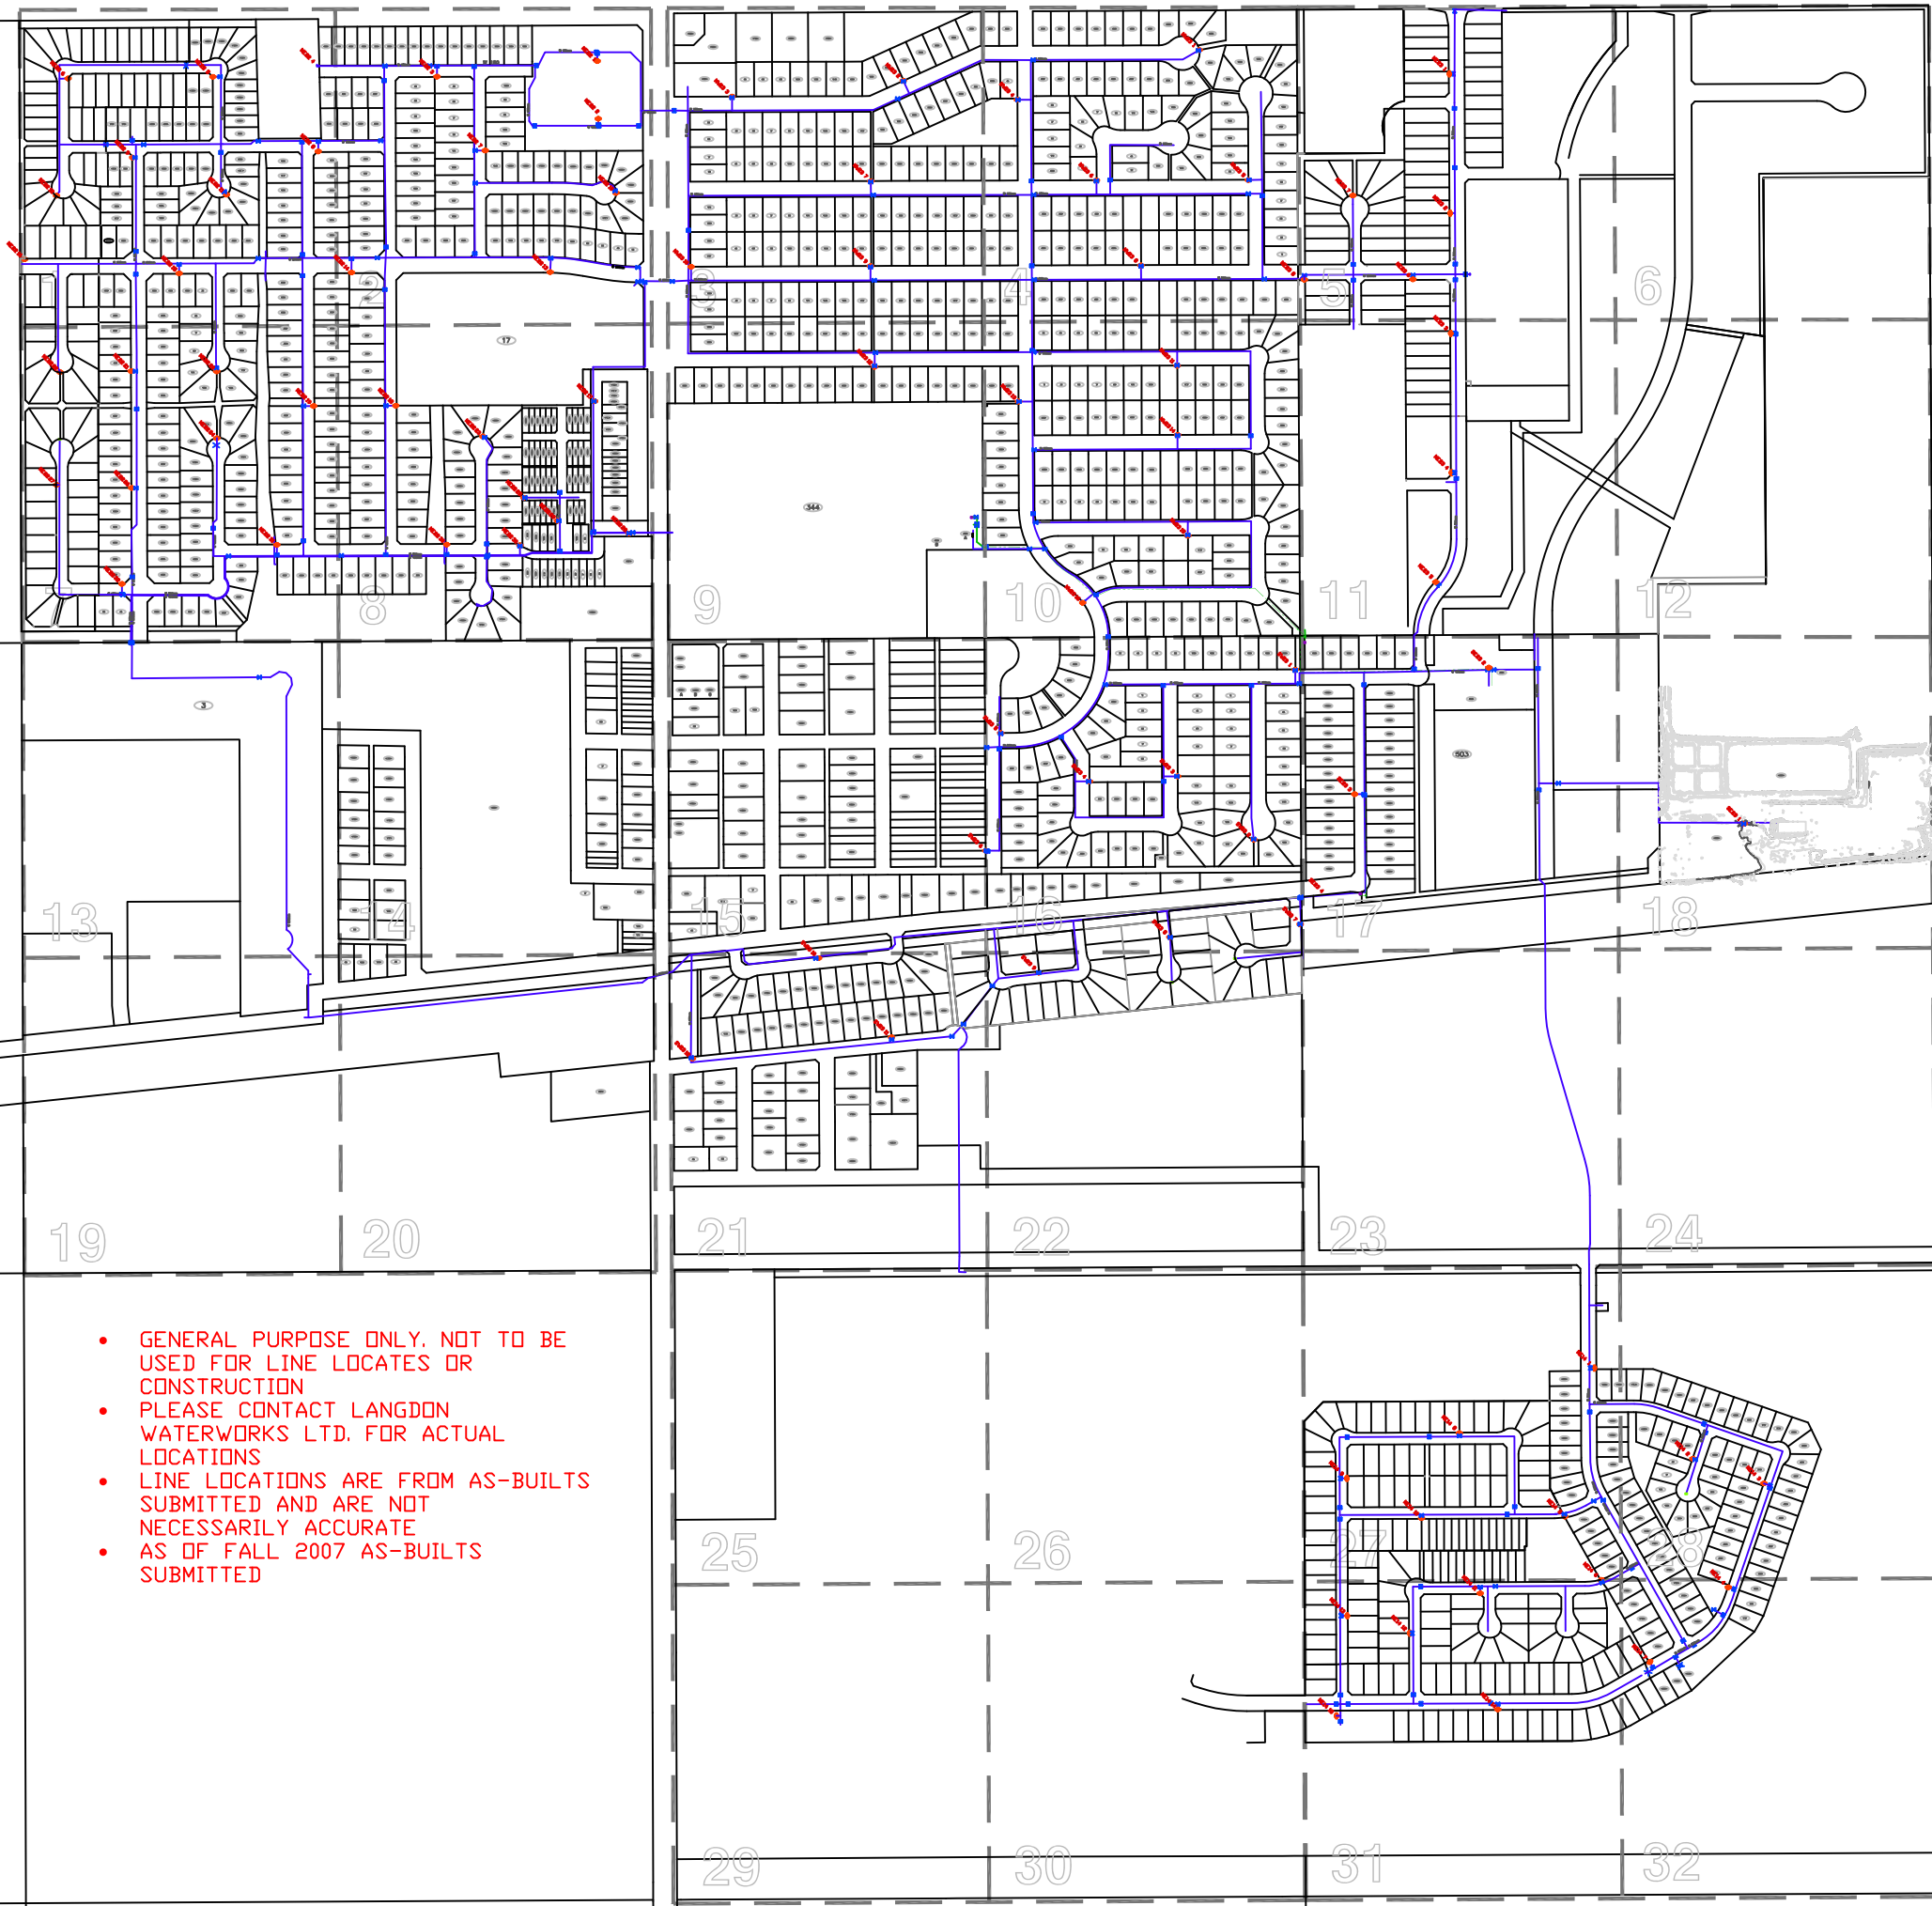

FIRE HYDRANT SCHEDULE

TOWNSHIP 14, RANGE 27 W4

FH#	QUARTER	SECTION	Position Z
1	NE	14	1005.242
2	NE	14	1006.308
3	NE	14	1006.441
4	NE	14	1005.93
5	NE	14	1005.899
6	NE	14	1005.92
7	NE	14	1005.774
8	NE	14	0
9	NE	14	0
10	NE	14	0
11	NE	14	0
12	NE	14	0
13	NE	14	0
14	NE	14	0
15	NE	14	0
1	NE	22	0
2	NE	22	0
3	NE	22	1007.867
4	NE	22	1006.992
5	NE	22	1008.274
6	NE	22	1008.063
7	NE	22	1006.649
8	NE	22	1006.578
9	NE	22	1007.475
10	NE	22	1008.049
11	NE	22	1008.141
12	NE	22	1008.815
13	NE	22	1005.734
14	NE	22	1007.48
15	NE	22	1007.689
16	NE	22	1007.189
17	NE	22	1005.83
18	NE	22	1006.042
19	NE	22	1006.158
20	NE	22	1008.586
21	NE	22	1007.321
22	NE	22	1008.415
23	NE	22	1006.339
24	NE	22	1008.507
25	NE	22	1006.31
26	NE	22	1007.015
27	NE	22	1007.919
28	NE	22	1006.68
29	NE	22	1006.516
30	NE	22	1006.157
31	NE	22	1006.058
32	NE	22	1006.44
1	NE	23	0
2	NE	23	0
3	NE	23	0
4	NE	23	0
5	NE	23	0
6	NE	23	0
7	NE	23	0
8	NE	23	1005.298
1	NW	23	1004.522
2	NW	23	1005.564
3	NW	23	1006.547
4	NW	23	1004.913
5	NW	23	1004.675
6	NW	23	1005.53

- GENERAL PURPOSE ONLY. NOT TO BE USED FOR LINE LOCATES OR CONSTRUCTION
- PLEASE CONTACT LANGDON WATERWORKS LTD. FOR ACTUAL LOCATIONS
- LINE LOCATIONS ARE FROM AS-BUILTS SUBMITTED AND ARE NOT NECESSARILY ACCURATE
- AS OF FALL 2007 AS-BUILTS SUBMITTED

LEGEND

- SANITARY: (Symbol)
- FORCE MAIN LINE: (Symbol)
- WATER MAIN VALVE: (Symbol)
- ELECTRICAL: (Symbol)
- CLEAN OUT: (Symbol)
- CATCH BASIN: (Symbol)
- WELL: (Symbol)
- WATER SUPPLY: (Symbol)
- WATER SUPPLY VALVE: (Symbol)
- FIRE HYDRANT: (Symbol)
- STORM MANHOLE: (Symbol)
- WATER VALVE: (Symbol)

DATE: 10/20/07 10:00 AM PROJECT: LANGDON WATERWORKS LTD. TOWNSHIP 14, RANGE 27 W4